

NOTICE

OR

PLAN OF OPERATIONS

(For Operations Proposed Under the 43 CFR 3809 Regulations)

MAR 17 1995

Bureau of Land Management
House Range/Warm Springs R.A.

Instructions to Claimant/Operator: Circle "Notice" (above) if proposed mining activity within the plan of operations will disturb a total of five (5) acres or less during the calendar year. Circle "Plan of Operations" if disturbance will exceed five (5) acres during the calendar year or if operations are within one of the specially designated areas described in 43 CFR 3809.1-4(b). Complete the form in as much detail as possible. Additional sheets may be used if necessary. Use maps or sketches where appropriate (maps or sketches are required for submitted plans of operations and are recommended for submitted notices). A review of the 43 CFR 3809 regulations should be conducted prior to completion of this form and submission to the appropriate BLM office.

Operator Information:Name

Steve Gale

AddressPO Box 855
Beaver Utah
84713Telephone

801 438 5676

Claimant Information (If different than operator):Name

Same

AddressTelephone

Claim Information (Claim names, circle claim types (Lode, Placer, Mill Site, Tunnel), UMC Serial Number. List only the claims where the disturbance is proposed):

Bud # 5 is located in Sec 26 NE 1/4
T5 23S R9W

Location of Proposed Activity (i.e. County, Township, Range, Section and Quarter section):

↑
Same as above

Describe Pre-Existing Disturbances and Structures or Indicate on Maps or Sketches (Mine and Mill Facilities, Workings, Tailings, Dump Areas, etc... It may be to your advantage to document existing disturbance with photographs):

There has been some cat work to the North of this claim, we will use road leading to this property

Describe Access Routes (Existing and proposed, for proposed road construction specify length and width in feet):

we will use mining road to mine just North of
use

Proposed Operations: Describe the entire proposed operation, including the type of material being removed and all surface disturbing activities (road construction, drilling, trenching, backhoe and bulldozer exploration, mining, waste disposal, etc.). List all mechanized earth moving equipment to be used during the operation and state if any hazardous materials or explosives are to be utilized. Describe and furnish a map or sketch, when applicable, showing existing surface disturbances, structures, facilities, etc., and the location and size of areas where surface disturbance are proposed, including existing and/or proposed routes of access. Calculate the total acreage proposed for disturbance (1 AC. = 43,560 sq. ft.).

we would like to dig some Test holes 4 to 5.
if objection is found we would like to
remove 5 to 10 Ton

Date Operations are Proposed to Commence as Outlined in this Submittal - (Month, Day, Year):

~~unknown~~ 3/16/95


Proposed Completion Date - (Month, Day, Year):

unknown

Proposed Reclamation: Describe the proposed reclamation procedures and other measures to be taken to prevent unnecessary or undue degradation of the lands, including measures to be taken if a period of non-operation is anticipated. When reclamation has been completed, the Authorized Officer of the BLM shall be notified so that an inspection of the area can be made.

we would reclaim as required by BLM

I hereby declare that I, or persons I have authorized to do so, will complete all necessary reclamation of areas disturbed during the course of my operations to the standards described in 43 CFR 3809.1-3(d) and that reasonable measure will be taken to prevent unnecessary or undue degradation of the federal lands during operations.



Signature of Claimant or Operator

3/17/95
Date

Notice to Claimants/Operators:

1. A notice submitted in relation to the 43 CFR 3809 regulations does not require approval from the BLM. However, notification of such activities shall be made at least 15 days before commencing operations. Approval of a submitted plan of operations is required from the BLM prior to commencing operations. The BLM will promptly acknowledge receipt of a plan and will notify the claimant/operator of the status of the plan within 30 days of receipt.
2. Approval of a plan of operations does not constitute certification of ownership to any person named as claimant/operator herein, nor does approval constitute recognition of the validity of any mining claims named herein.
3. Information and data submitted and specifically identified by the operator as containing trade secrets or confidential or privileged commercial or financial information should be attached to a separate page and cited in the text of the notice or plan of operations. This information will be filed separately by the BLM and will not be available for public inspection.
4. Failure of an operator to file a notice under 3809.1 - 3 or a plan of operations under 3809.1 - 4 will be subject to the operator, at the discretion of the authorized officer, to being served a notice of non-compliance or enjoined from the continuation of such

Bud #5
Mining Claim

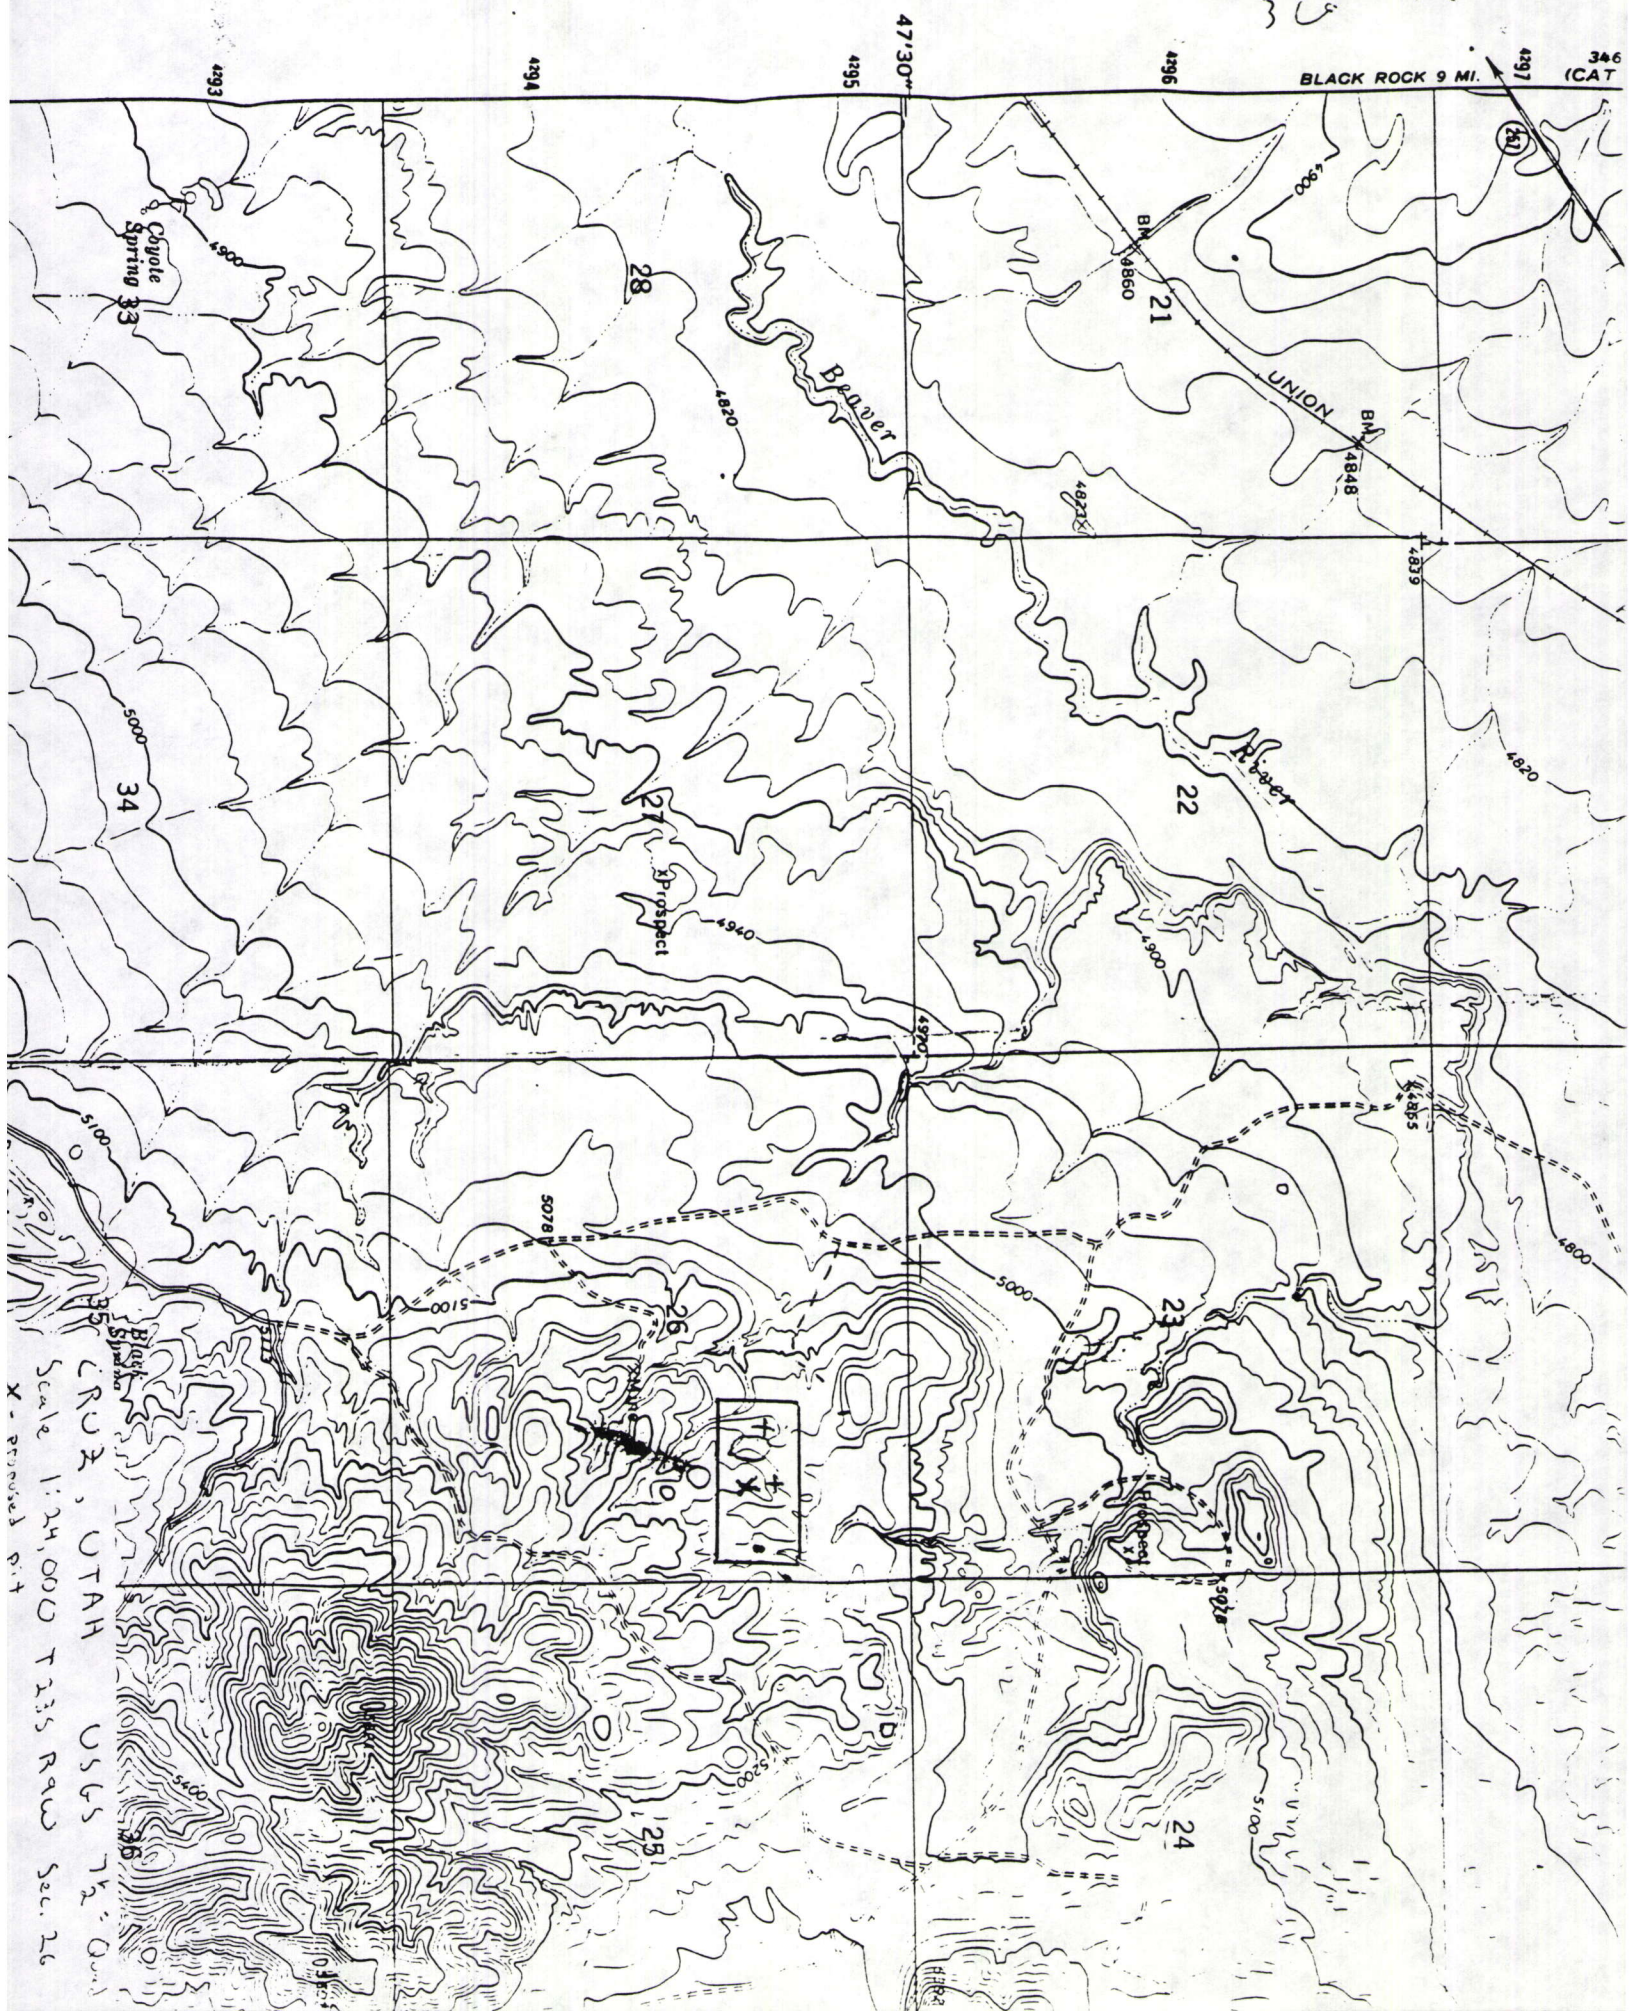


CRUZ, UTAH USGS 7.5" Quad
Scale 1:24,000 T235 RAW Sec. 26
X - removed pit

NOTICE
OR

1 acre

PLAN OF OPERATIONS

(For Operations Proposed Under the 43 CFR 3809 Regulations)

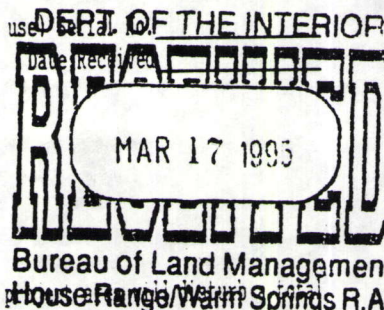

Instructions to Claimant/Operator: Circle "Notice" (above) if proposed mining activity within the plan of five (5) acres or less during the calendar year. Circle "Plan of Operations" if disturbance will exceed five (5) acres during the calendar year or if operations are within one of the specially designated areas described in 43 CFR 3809.1-4(b). Complete the form in as much detail as possible. Additional sheets may be used if necessary. Use maps or sketches where appropriate (maps or sketches are required for submitted plans of operations and are recommended for submitted notices). A review of the 43 CFR 3809 regulations should be conducted prior to completion of this form and submission to the appropriate BLM office.

Operator Information:Name

Steve Gale

AddressPO Box 855
Brewer Utah
84713Telephone

801 4385676

Claimant Information (If different than operator):NameRodney Green
~~Green~~Address

Brewer

Telephone

Claim Information (Claim names, circle claim types (Lode, Placer, Mill Site, Tunnel), UMC Serial Number. List only the claims where the disturbance is proposed):

Bud #4

Location of Proposed Activity (i.e. County, Township, Range, Section and Quarter section):

in SE 1/4 of Sec 23 T23S 9W)

See Map.

Bud #4

Describe Pre-Existing Disturbances and Structures or Indicate on Maps or Sketches (Mine and Mill Facilities, Workings, Tailings, Dump Areas, etc...). It may be to your advantage to document existing disturbance with photographs):

there is an old dig on this claim
a trench 5' deep 20' long

Describe Access Routes (Existing and proposed, for proposed road construction specify length and width in feet):

a dirt road goes through south end of claim

Proposed Operations: Describe the entire proposed operation, including the type of material being removed and all surface disturbing activities (road construction, drilling, trenching, backhoe and bulldozer exploration, mining, waste disposal, etc.). List all mechanized earth moving equipment to be used during the operation and state if any hazardous materials or explosives are to be utilized. Describe and furnish a map or sketch, when applicable, showing existing surface disturbances, structures, facilities, etc., and the location and size of areas where surface disturbance are proposed, including existing and/or proposed routes of access. Calculate the total acreage proposed for disturbance (1 AC. = 43,560 sq. ft.).

we would like to dig 4 to five test holes
if we find some obsidian we would like remove
5 to 20 tons of product, dig will be done with
case Tractor hoe -

Date Operations are Proposed to Commence as Outlined in this Submittal - (Month, Day, Year):

3/16/95


Proposed Completion Date - (Month, Day, Year):


unknown

Proposed Reclamation: Describe the proposed reclamation procedures and other measures to be taken to prevent unnecessary or undue degradation of the lands, including measures to be taken if a period of non-operation is anticipated. When reclamation has been completed, the Authorized Officer of the BLM shall be notified so that an inspection of the area can be made.

we will reclaim as required by BLM

I hereby declare that I, or persons I have authorized to do so, will complete all necessary reclamation of areas disturbed during the course of my operations to the standards described in 43 CFR 3809.1-3(d) and that reasonable measure will be taken to prevent unnecessary or undue degradation of the federal lands during operations.

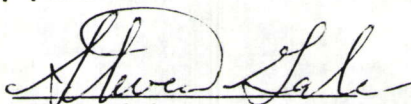
Signature of Claimant or Operator

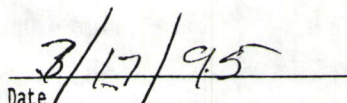
Date

Notice to Claimants/Operators:

1. A notice submitted in relation to the 43 CFR 3809 regulations does not require approval from the BLM. However, notification of such activities shall be made at least 15 days before commencing operations. Approval of a submitted plan of operations is required from the BLM prior to commencing operations. The BLM will promptly acknowledge receipt of a plan and will notify the claimant/operator of the status of the plan within 30 days of receipt.
2. Approval of a plan of operations does not constitute certification of ownership to any person named as claimant/operator herein, nor does approval constitute recognition of the validity of any mining claims named herein.
3. Information and data submitted and specifically identified by the operator as containing trade secrets of confidential or privileged commercial or financial information should be attached to a separate page and cited in the text of the notice or plan of operations. This information will be filed separately by the BLM and will not be available for public inspection.
4. Failure of an operator to file a notice under 3809.1 - 3 or a plan of operations under 3809.1 - 4 will be subject to the operator, at the discretion of the authorized officer, to being served a notice of non-compliance or enjoined from the continuation of such

Bld #4 Mining Claim


BLACK ROCK 9 MI. (CAT)

47°30'

4295

4294

4293

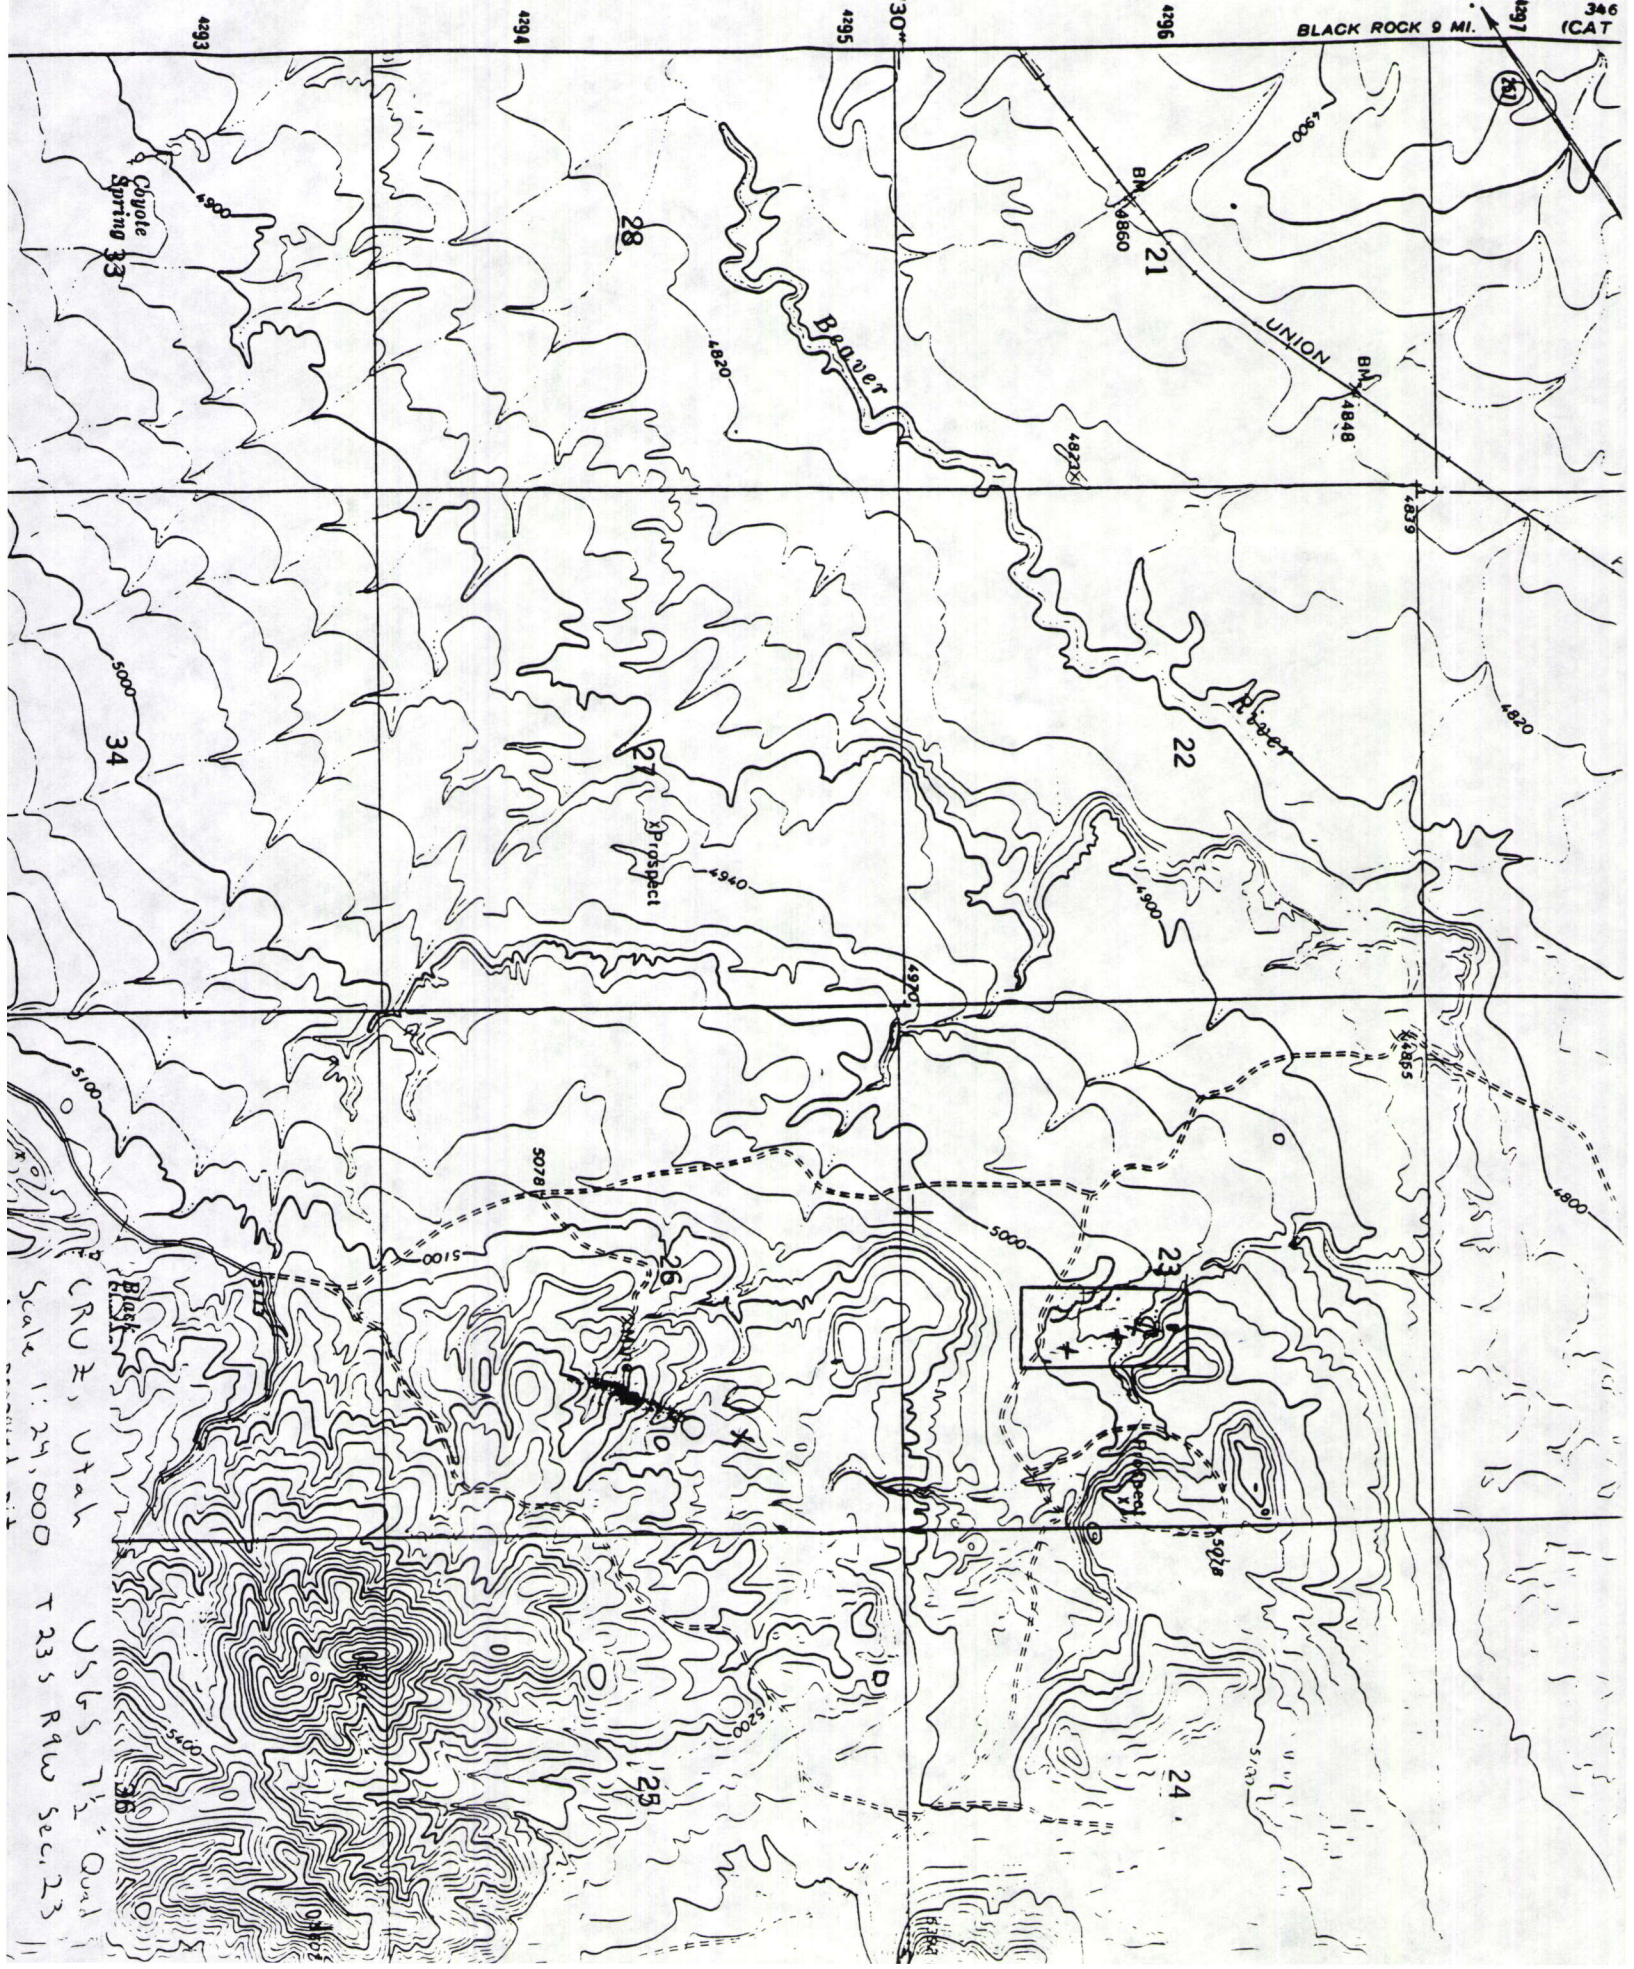

CRUZ, Utah USGS 7 1/2" Quad
Scale 1:24,000 T23 R4W Sec. 23